

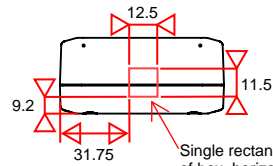
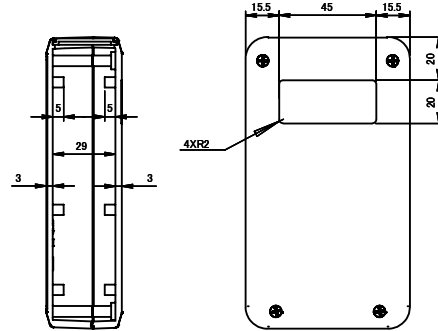
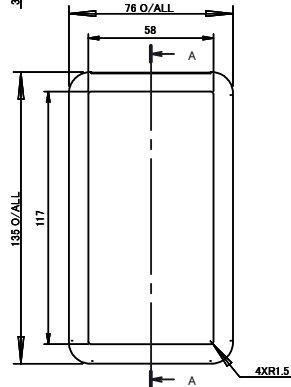


ASSEMBLY


ISO VIEW
2:7

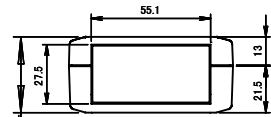

Single rectangular hole straddling top and base of box, horizontally central (USB connector)

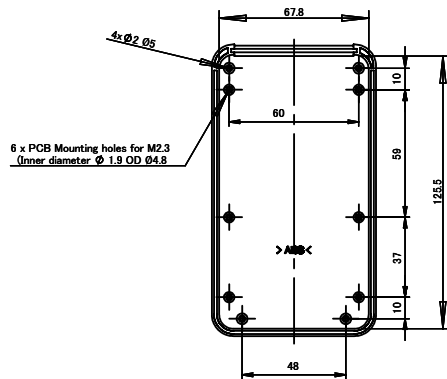

6 x PCB Mounting holes for M2.3
(Inner diameter Ø 1.9 OD Ø4.8)

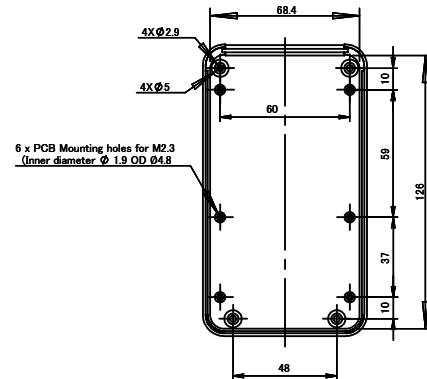


6 x PCB Mounting holes for M2.3
(Inner diameter Ø 1.9 OD Ø4.8)

TOP

BASE


Slot 1mm wide, 51.5mm deep, open at left end

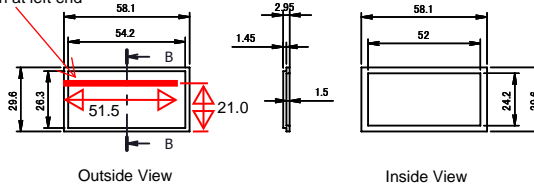

Outside View

Inside View


PANEL

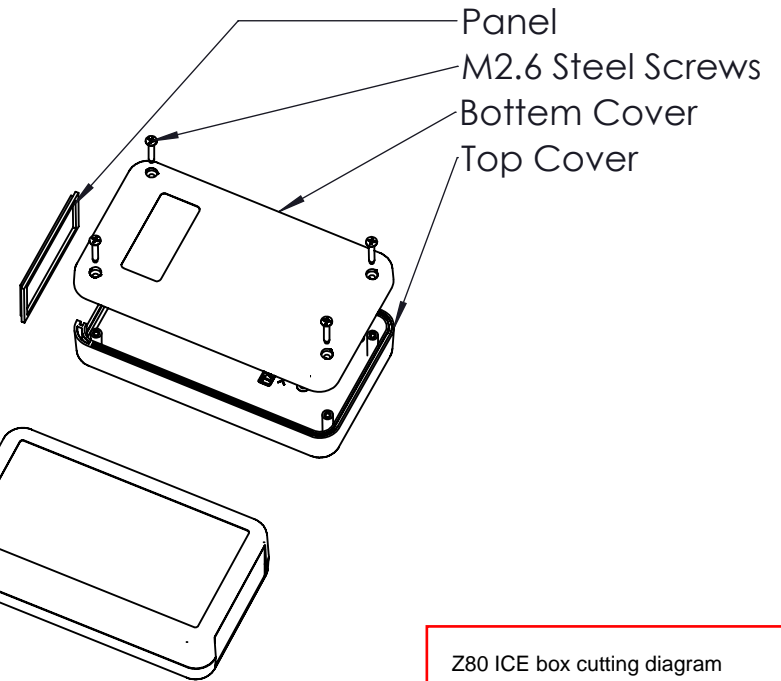

Z80 ICE box cutting diagram

New holes shown in red.
Dimensions in mm.

Debug Innovations Ltd.
Drawing V1, 6 March 2024

<div></div> <div>CAMDENBOSS</div> <div>JAMES CARTER RD, MILDENHALL, SUFFOLK, IP28 7DE TEL: 01638 716101 FAX: 01638 716554 EMAIL: Sales@CamdenBoss.com WEB: www.CamdenBoss.com</div>				UNLESS OTHERWISE SPECIFIED: DIMENSIONS ARE IN MILLIMETERS		DO NOT SCALE DRAWING		REVISION. <div><div></div></div>	
				GENERAL TOLERANCES +/- 0.2		TITLE: <div>87 SERIES SILICON COVER ENCLOSURES, SIZE 4, WHITE, 135x76x35</div>			
				FINISH. FINE TEXTURE					
				MATERIAL. ABS UL94-V0		DWG NO. CHH874WHN		A4	
DRAWN	LEWIS LETCHFORD	L.L.	11/02/2014	PROJECTION. <div><div></div><div></div></div>		SCALE. 2:7		SHEET 1 OF 1	
CHK'D	IAN PAGANO	I.P.	21/02/14						

A4